



4e étage

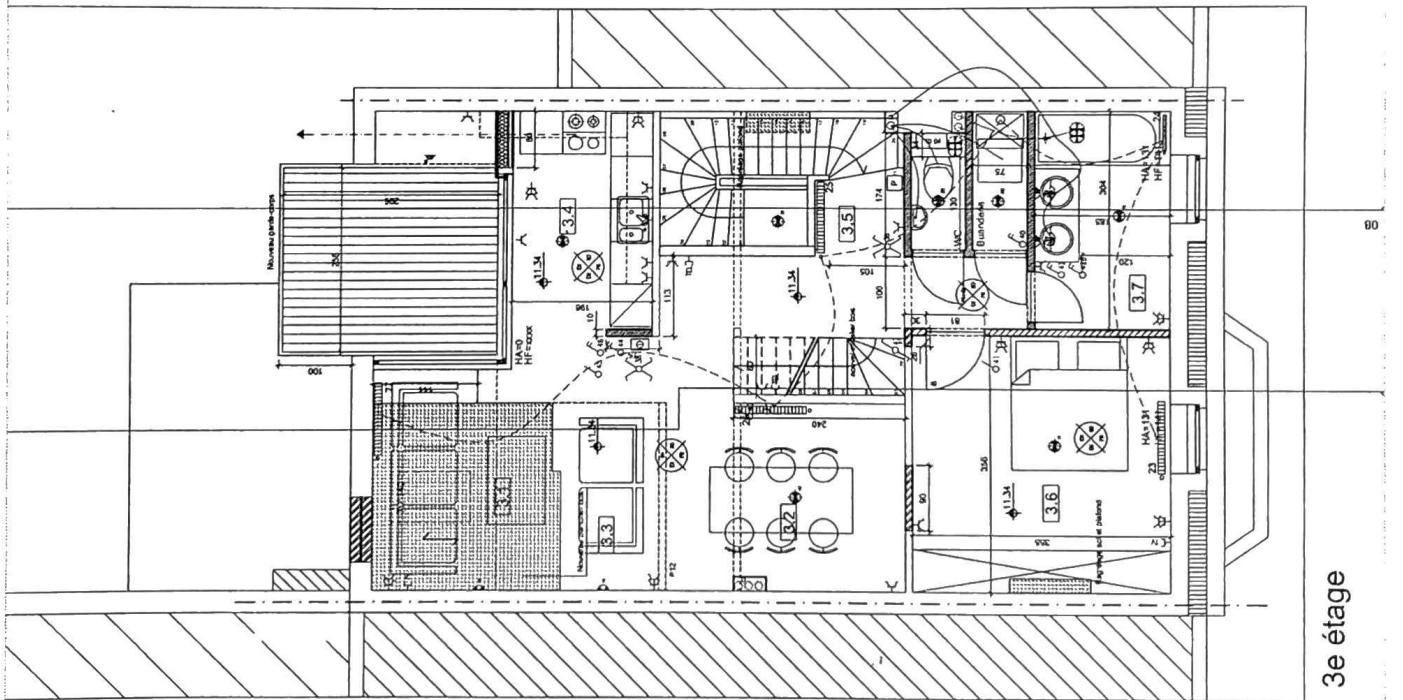


3e étage

ARCHITECTES: URBAN PLATFORM, sc.	PROJET Thornell Housing			PLAN AS - BUILT				
	MAITRE DE L'OUVRAGE: Beloft sprl	CODE 059b	ETAPE exe	ECHELLE 1/100	TYPE P	EMET. A	DATE 22/03/07	N°PLAN

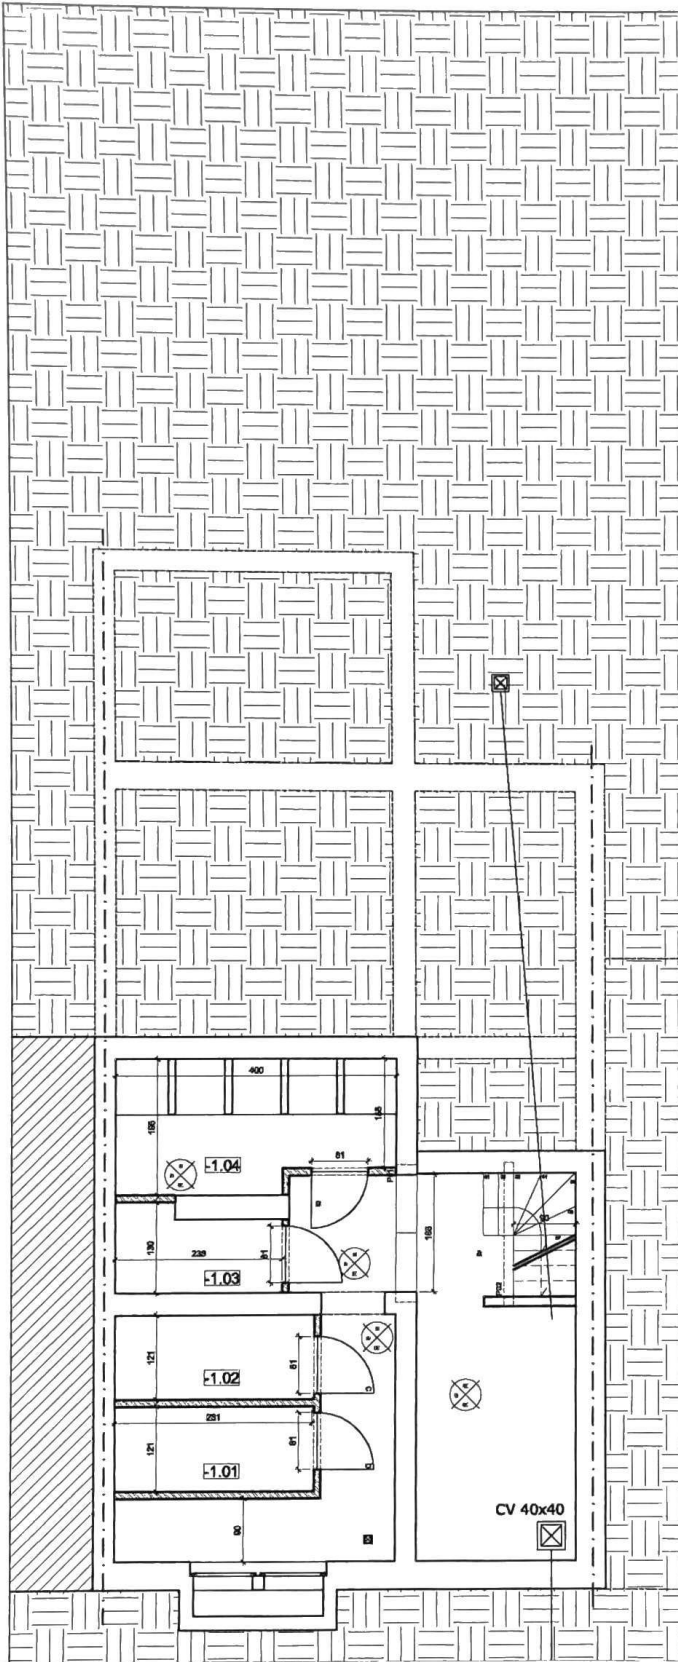

CAVES

- Cave -1.01 (appt rez): 3,4m²
- Cave -1.02 (appt +1): 3,4m²
- Cave -1.03 (appt +2): 2,7m²
- Cave -1.04 (duplex +3+4): 7,2m²

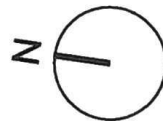

MAITRE DE L'OUVRAGE: Beloft sprl.		ARCHITECTES: URBAN PLATFORM, sc.				
PROJET Thornell HOUSING		CODE	ETAPE	ECHELLE	TYPE	EMET.
		059b	AsB	1/100e	P	A
PLAN CAVES <i>As Built</i>		ZONE	NIV.	ORIENT.	DATE	N°PLAN
					18/09/07	